

780  
 WEST LUPINE DRIVE  
 ASPEN, CO. 81611

MAIN LEVEL  
 2,505 sq. ft.


SCALE:  
 1/4" = 1'

DATE: 10/15/2015


PROJECT: AS BUILTS

CARETAKERS UNIT  
 802 sq. ft.


SHEET:  
 B-1

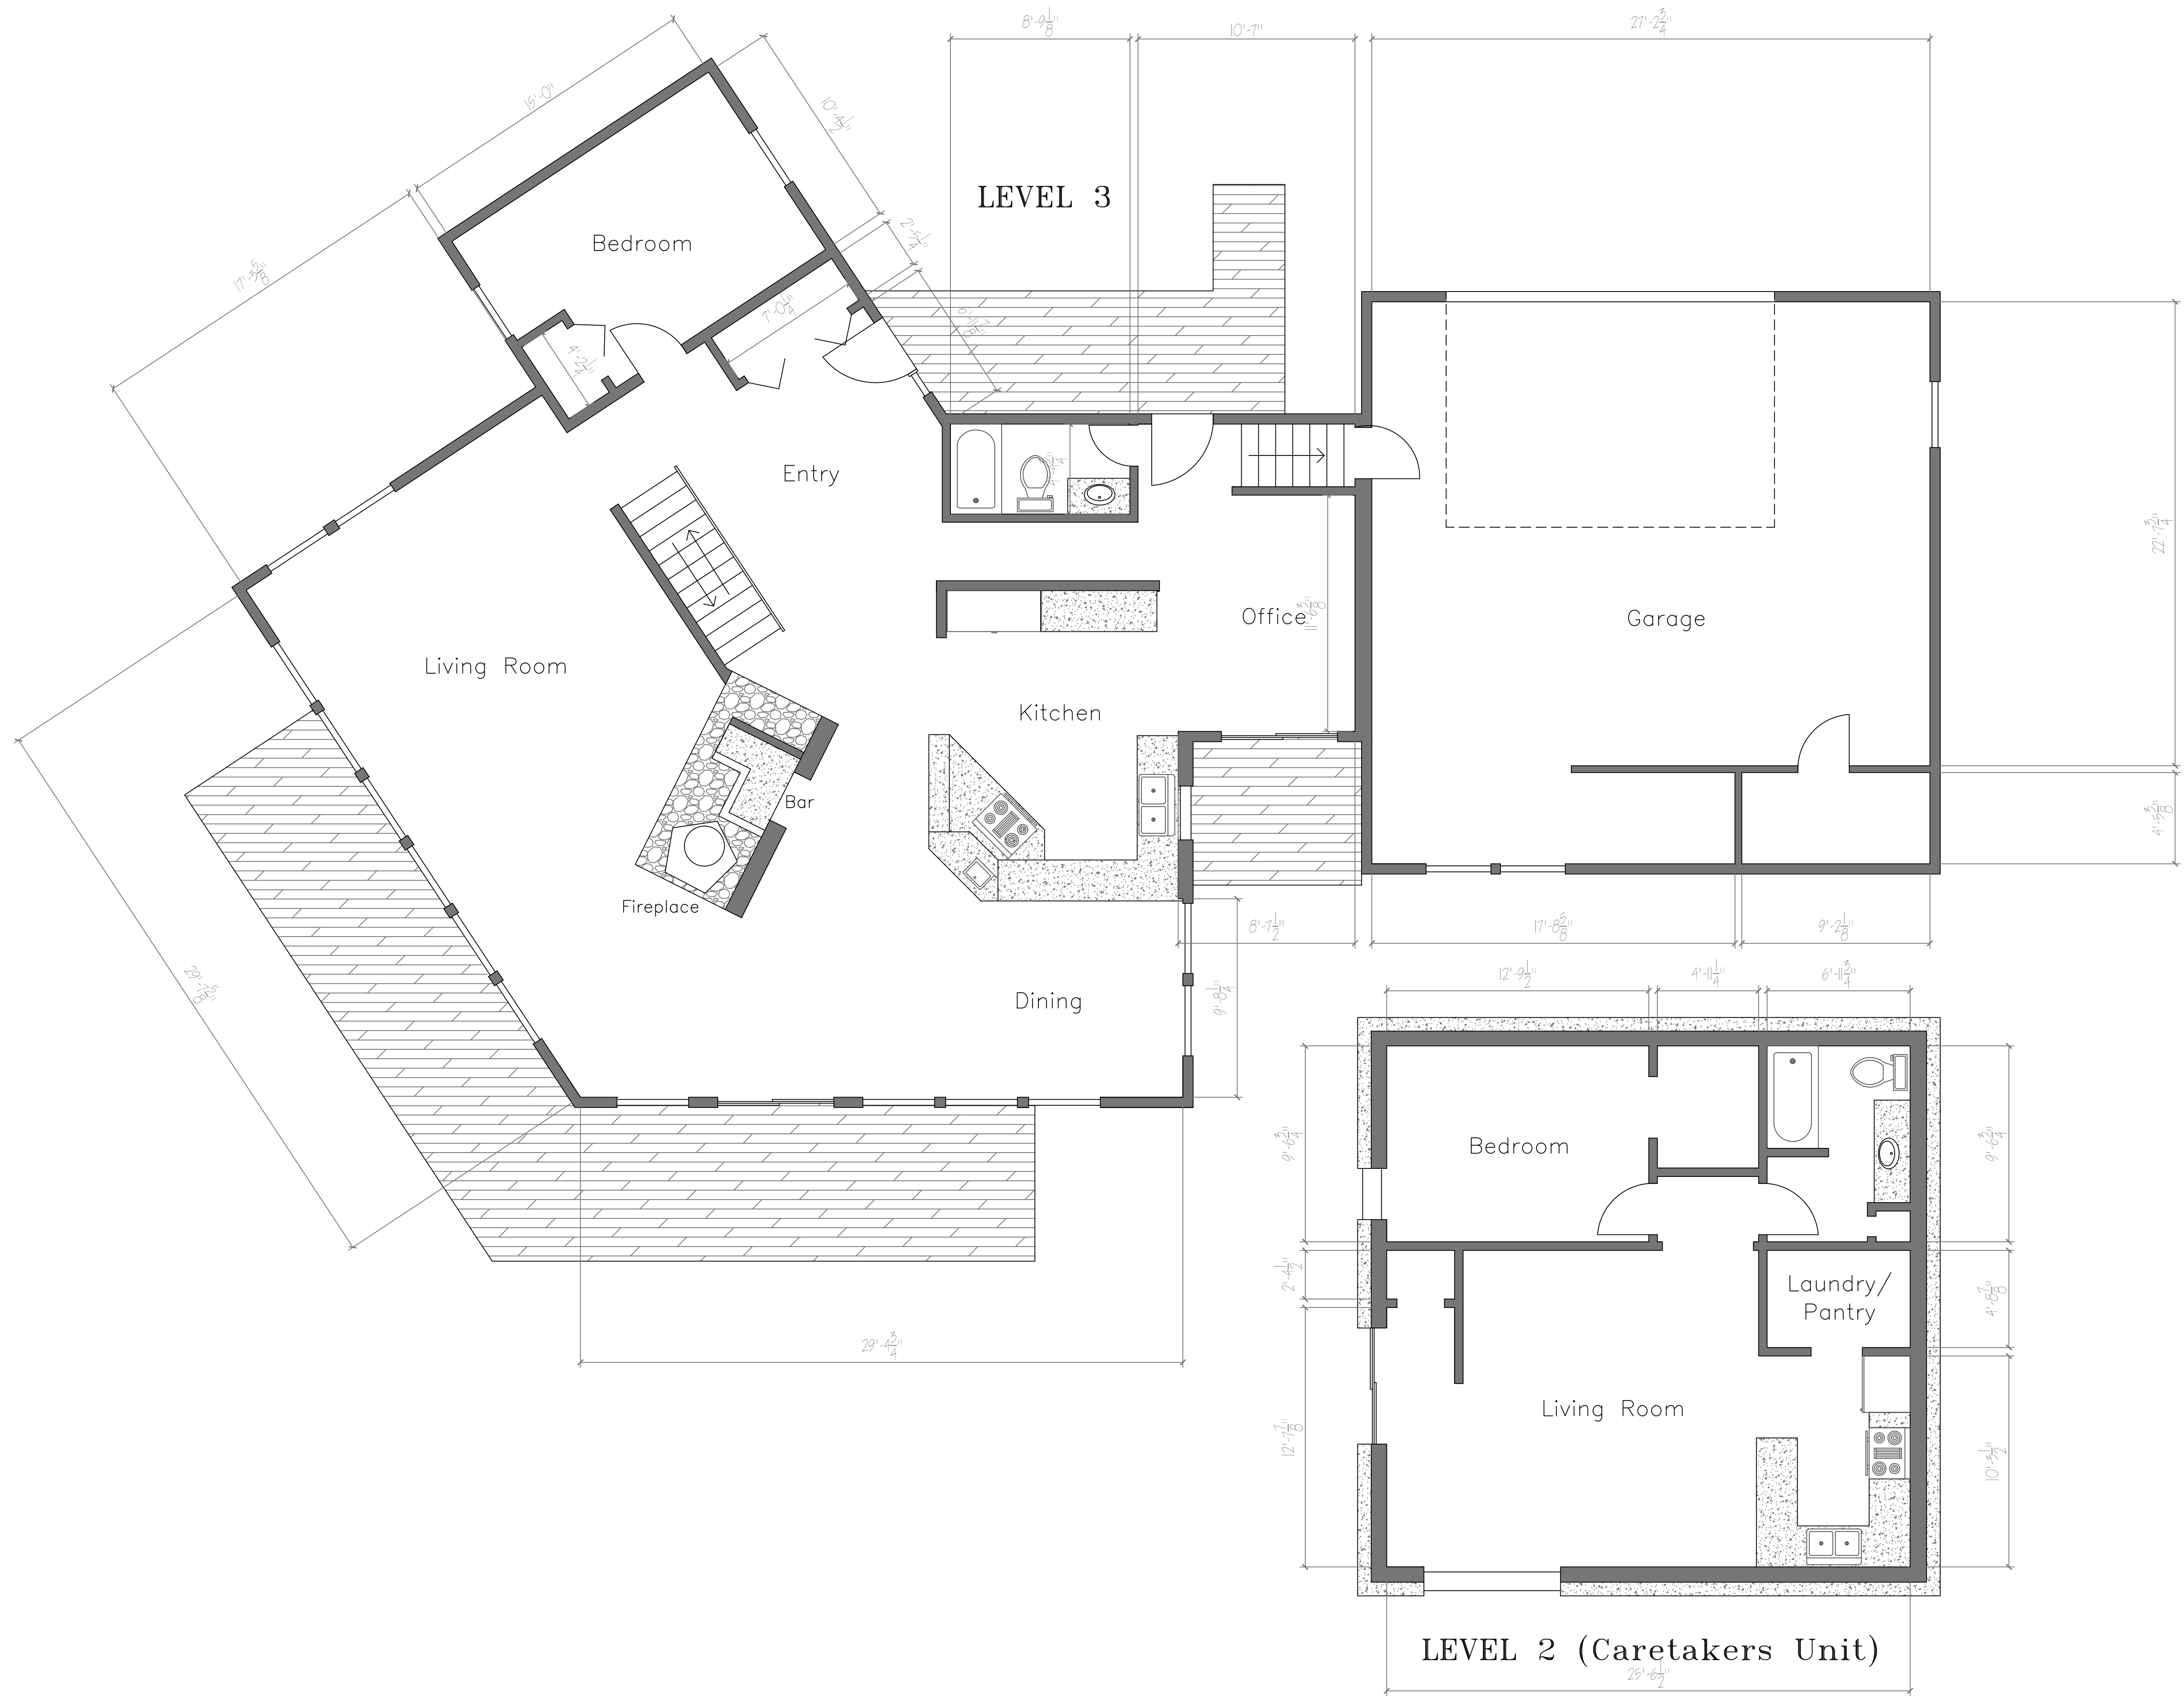

DRAWINGS BY:

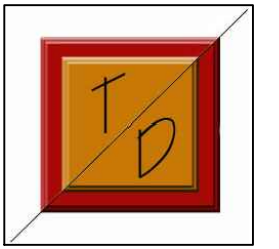

TRUE DIMENSIONS  
ASPEN@TRUEDIMENSIONS.COM  
970.618.8551

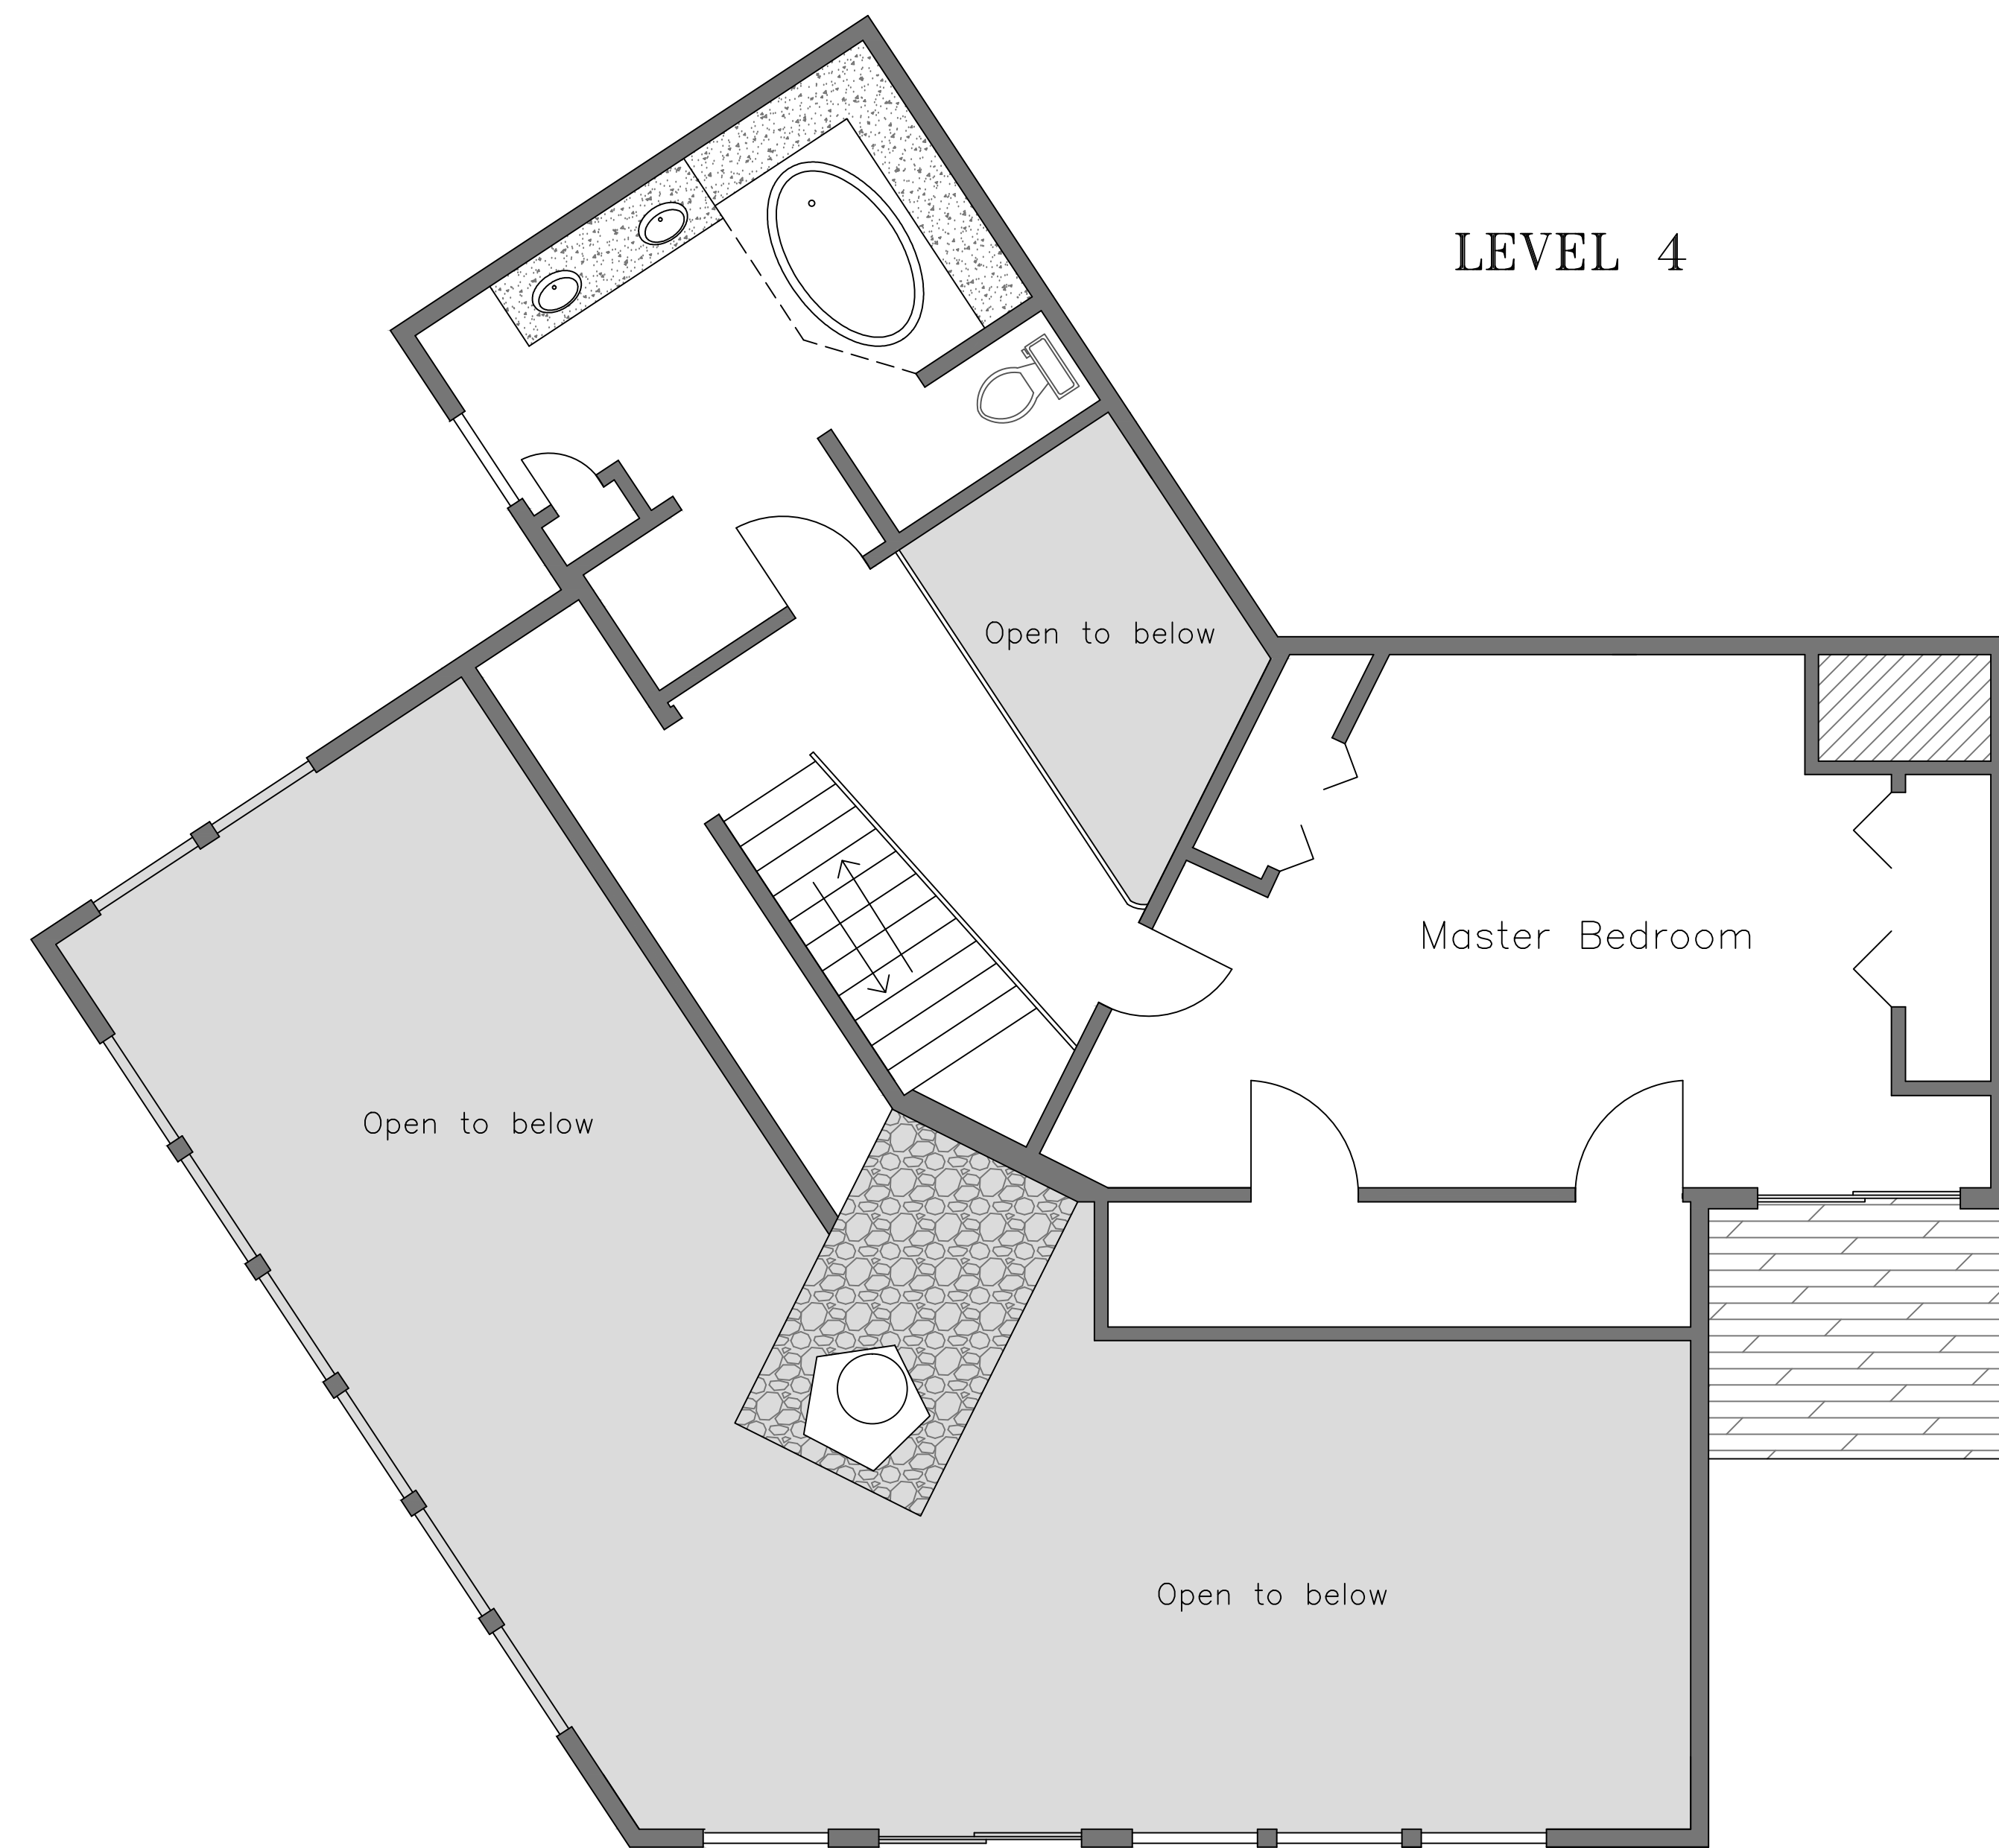

780  
WEST LUPINE DRIVE  
ASPEN, CO. 81611

LEVEL 4  
857 sq. ft.

SCALE:

1/4" = 1'


DATE: 10/15/2015

PROJECT: AS BUILTS


SHEET:

A-2

LEVEL 2

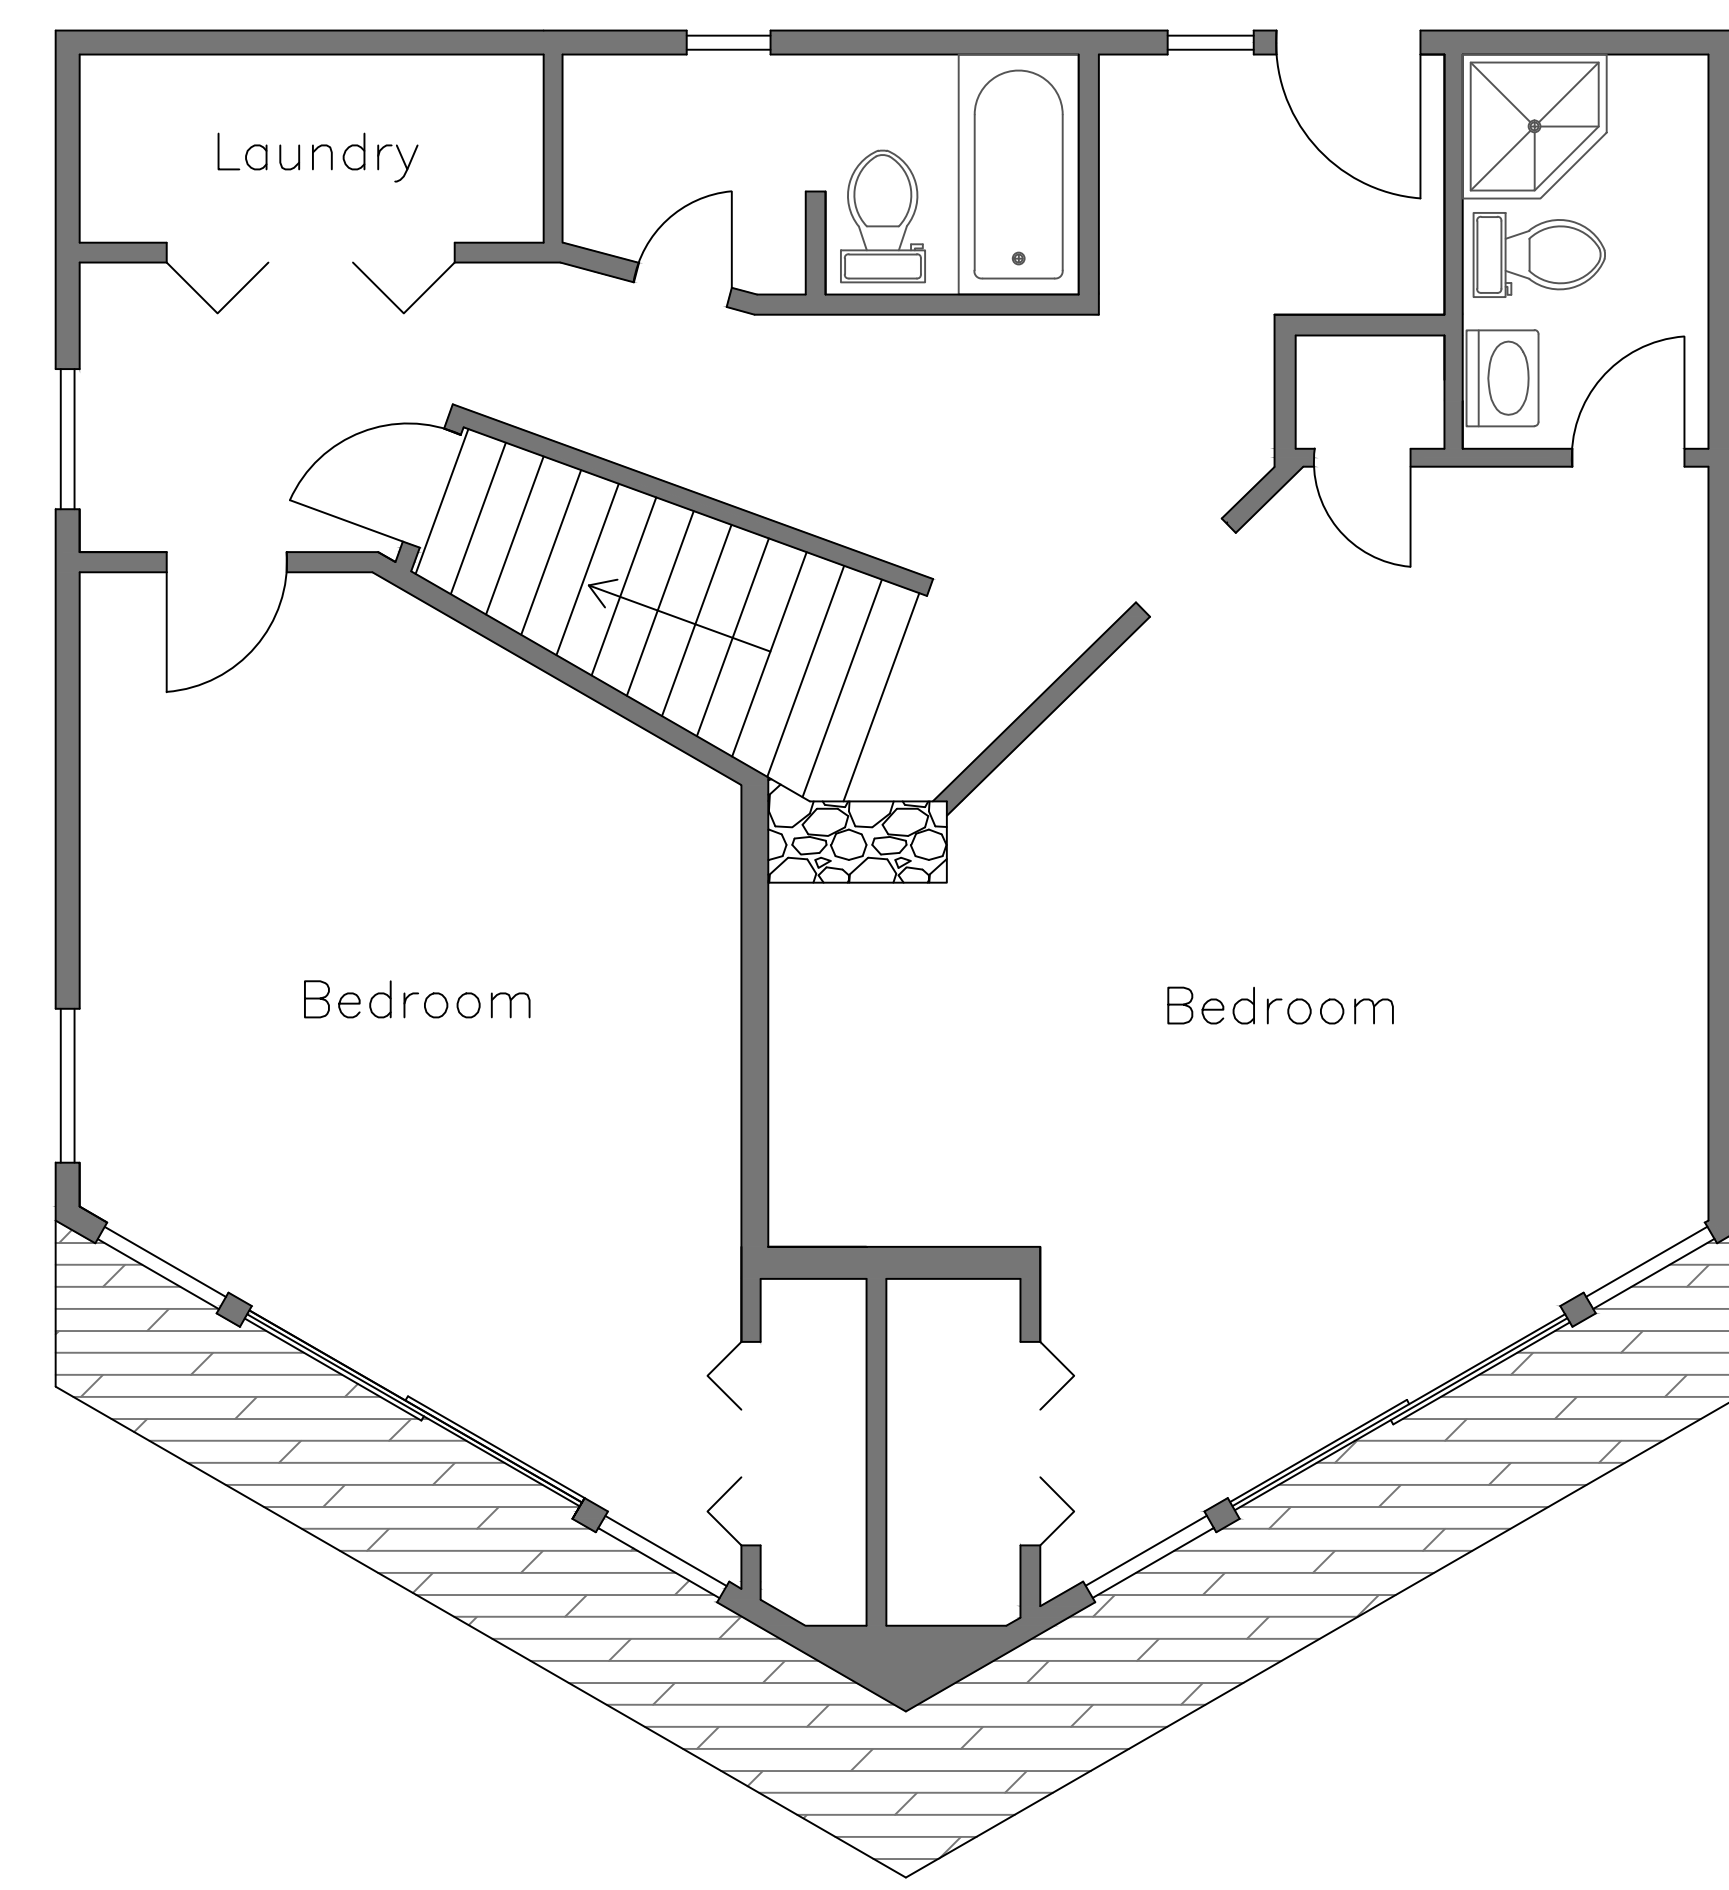

LEVEL 1

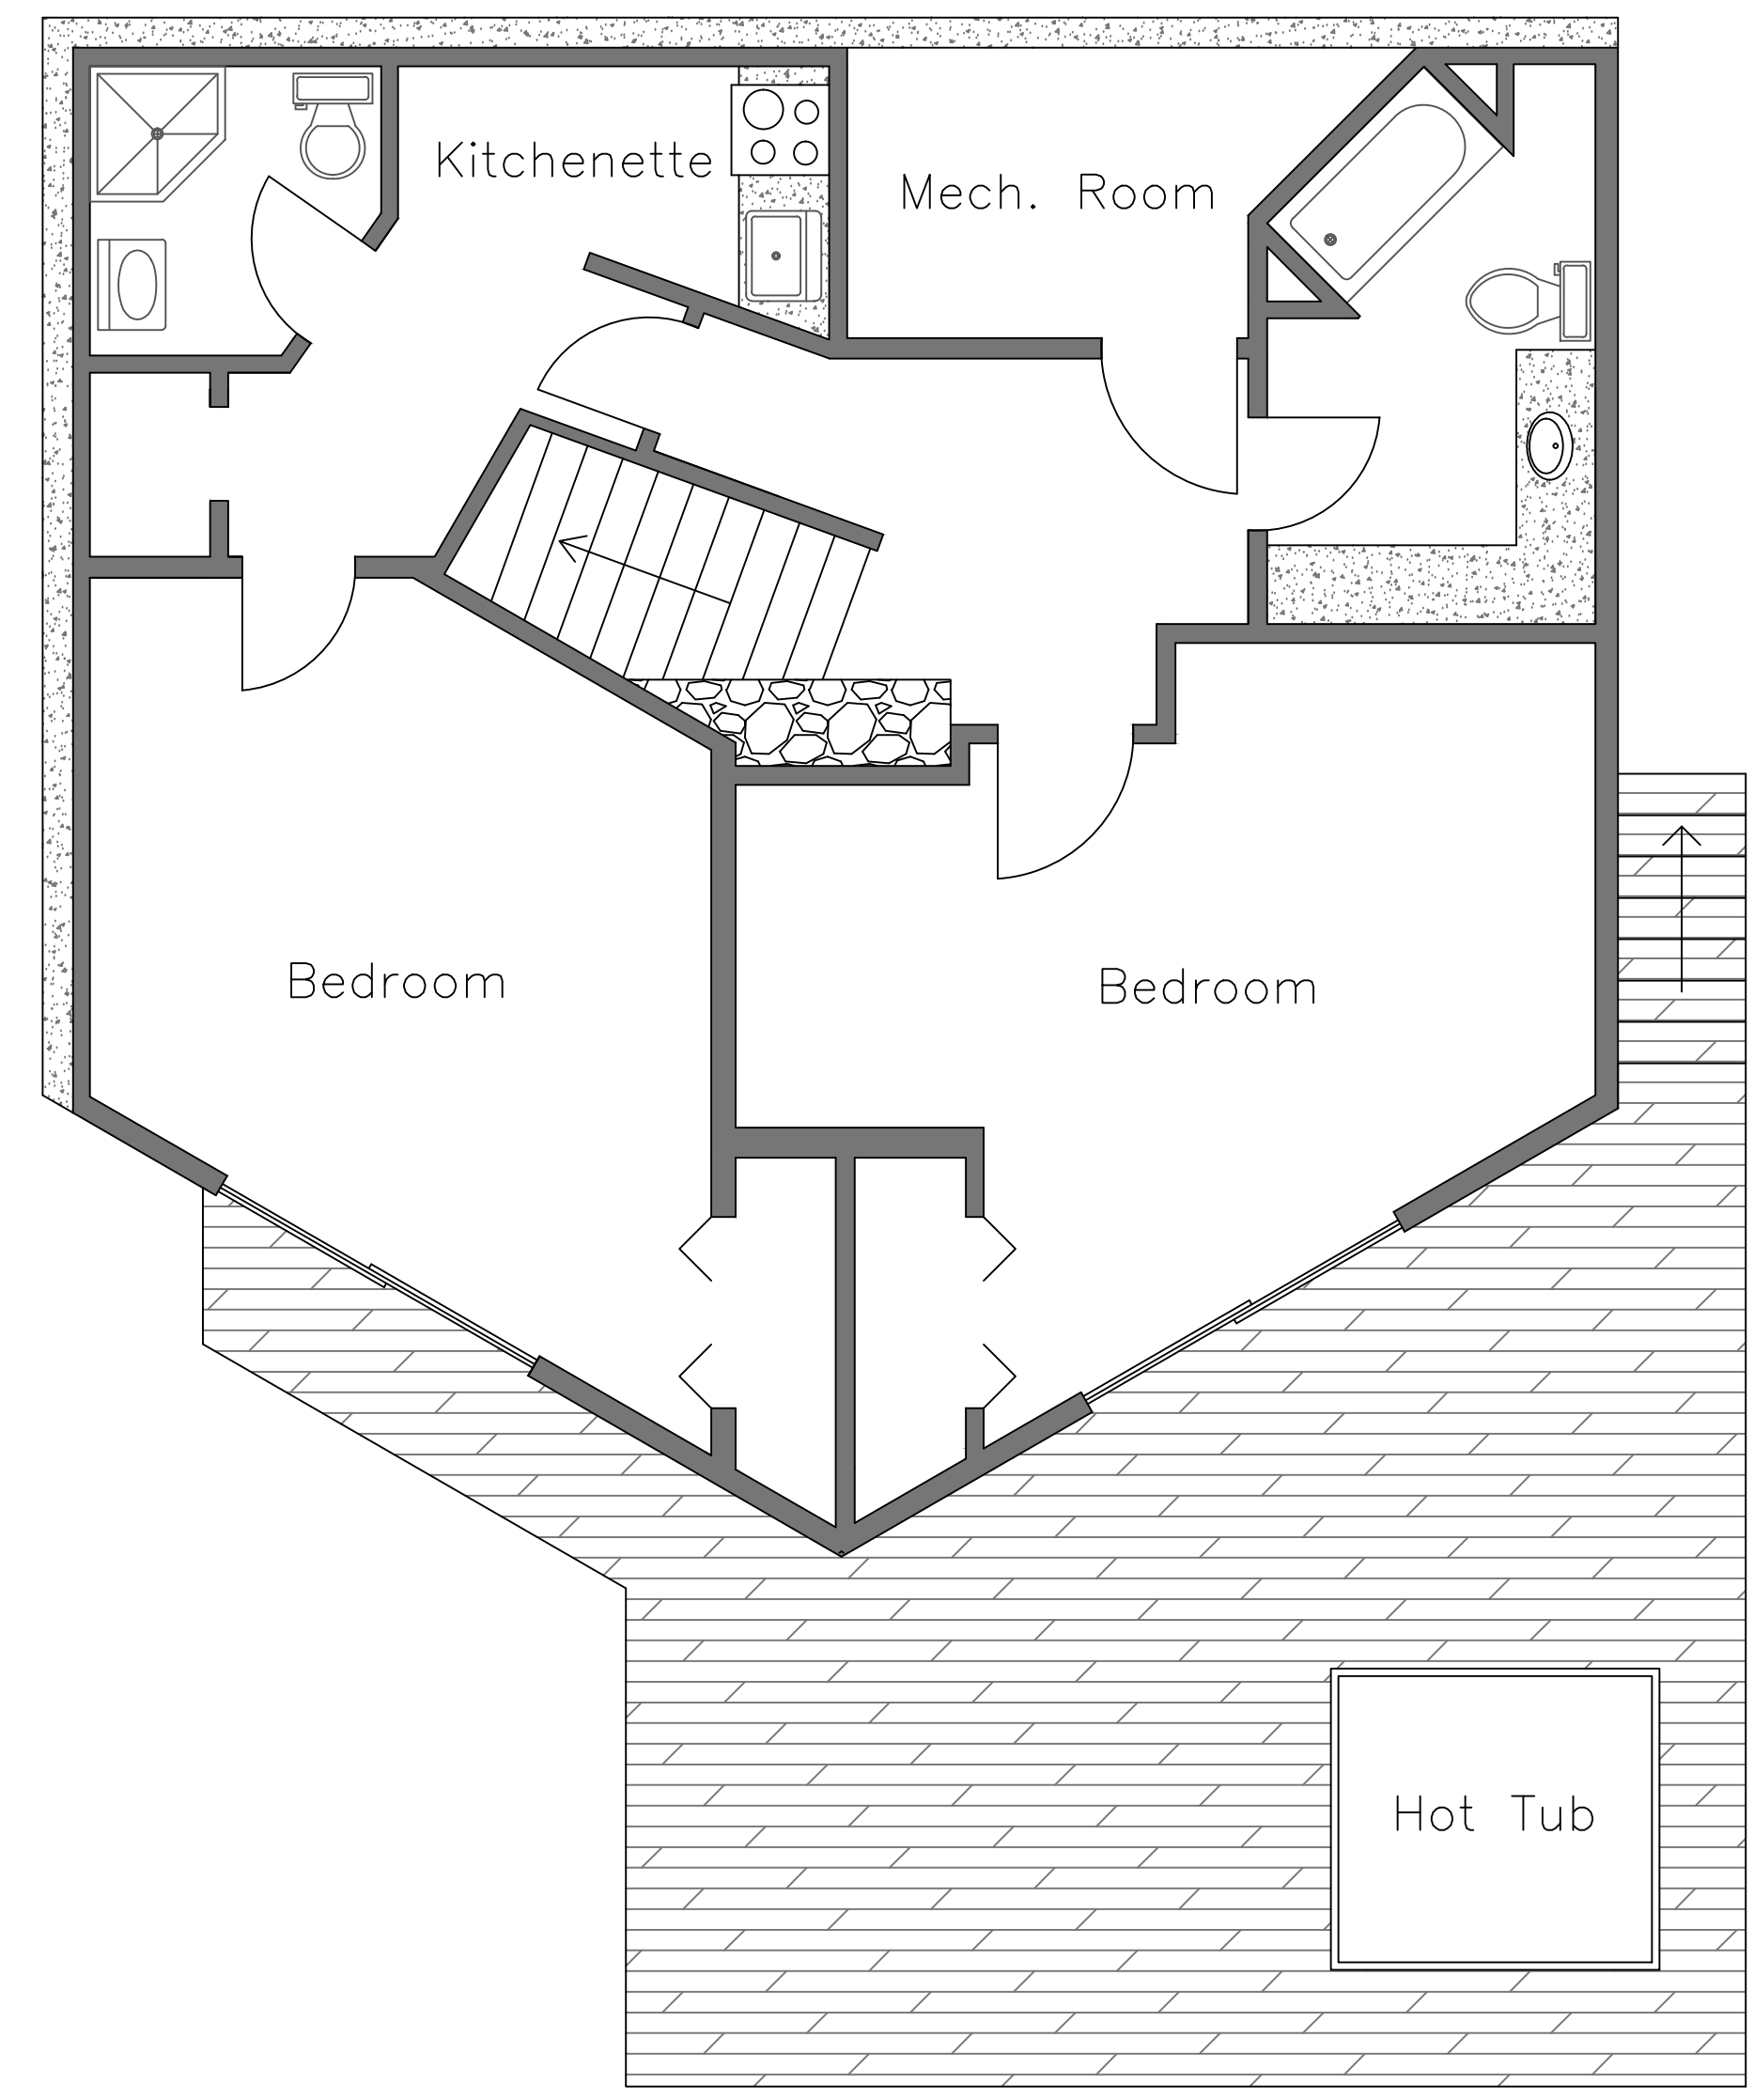

780  
 WEST LUPINE DRIVE  
 ASPEN, CO. 81611

LEVELS 1&2  
 2,086 sq. ft.

SCALE:  
 1/4" = 1'

DATE:  
 10/15/2015

PROJECT:  
 AS BUILTS

SHEET:  
 A - 3